


EXIST. BATHHOUSE PLUMBING PLAN
SCALE: 1/8"=1'-0"

HANDICAPPED SHOWER DETAIL
NOT TO SCALE

MARK	FIXTURE TYPE	MF'R	FIXTURE NO.	SIZE	TRIM	SUPPLIES	WASTE	TRAP	ROUGHING-IN CONNECTIONS			
									C.W.	H.W.	WASTE	VENT
P-1	LAVATORY		EXIST.			Z-8802-LR ^①		Z-8700-8 ^①	EXIST.	1/2"	EXIST.	EXIST.
P-2	LAVATORY	KOHLER	K-2890-4	20"x18"	SYMMONS S-902FRGIPS	Z-8802-LR ^①		Z-8700-8 ^①	1/2"	1/2"	1-1/4"	EXIST.
P-3	WATER CLOSET		EXIST.		CHURCH 9400KC	EXIST.			EXIST.		EXIST.	EXIST.
P-4	WATER CLOSET	KOHLER	K-4302		CHURCH 9400KC	ZURN Z-6000XL-WSI			1"		4"	2"
P-5	WATER CLOSET	DO	K-4350		CHURCH 9400KC	ZURN Z-6000XL-WSI			1"		4"	1-1/4"
P-6	URINAL		EXIST.						EXIST.		EXIST.	EXIST.
P-7	URINAL	KOHLER	K-4972-T			ZURN Z-6003XL-WSI			3/4"		2"	1-1/4"
P-8	SHOWER HEAD		EXIST.						EXIST.	EXIST.		
P-9	SHOWER HEAD	CHICAGO			752	W/TRIM			1/2"	1/2"		
P-10	HANDICAPPED SHOWER	CHICAGO			752-317	W/TRIM			1/2"	1/2"		
P-11	ELECTRIC WATER COOLER	OASIS	PLF8WMD	8.0 GPH	W/UNIT	1/2" BALL VALVE	W/UNIT	Z-8700-8 ^①	EXIST.		EXIST.	
P-12	FLOOR DRAIN	ZURN	ZN-415BP	6"ø				PVC "P"			3"	
P-13	SERVICE SINK	KOHLER	K-6719	24"x20"	CHICAGO 835	1/2" BALL VALVE	W/TRAP	K-6673	1/2"	1/2"	3"	2"


NOTES:
 ① INDICATES MCGUIRE MODEL NUMBER
 ② MOUNT P-7 ON ZURN CARRIER MODEL Z-1222

MARK	MF'R.	MODEL NO.	CAPACITY GALS.	HEATING ELEMENTS # - KW	VOLTAGE	CONTROL
WH-1	STATE	TCL-82-2LRT	82	2 - 6.0	240/1ø	BUILT-IN

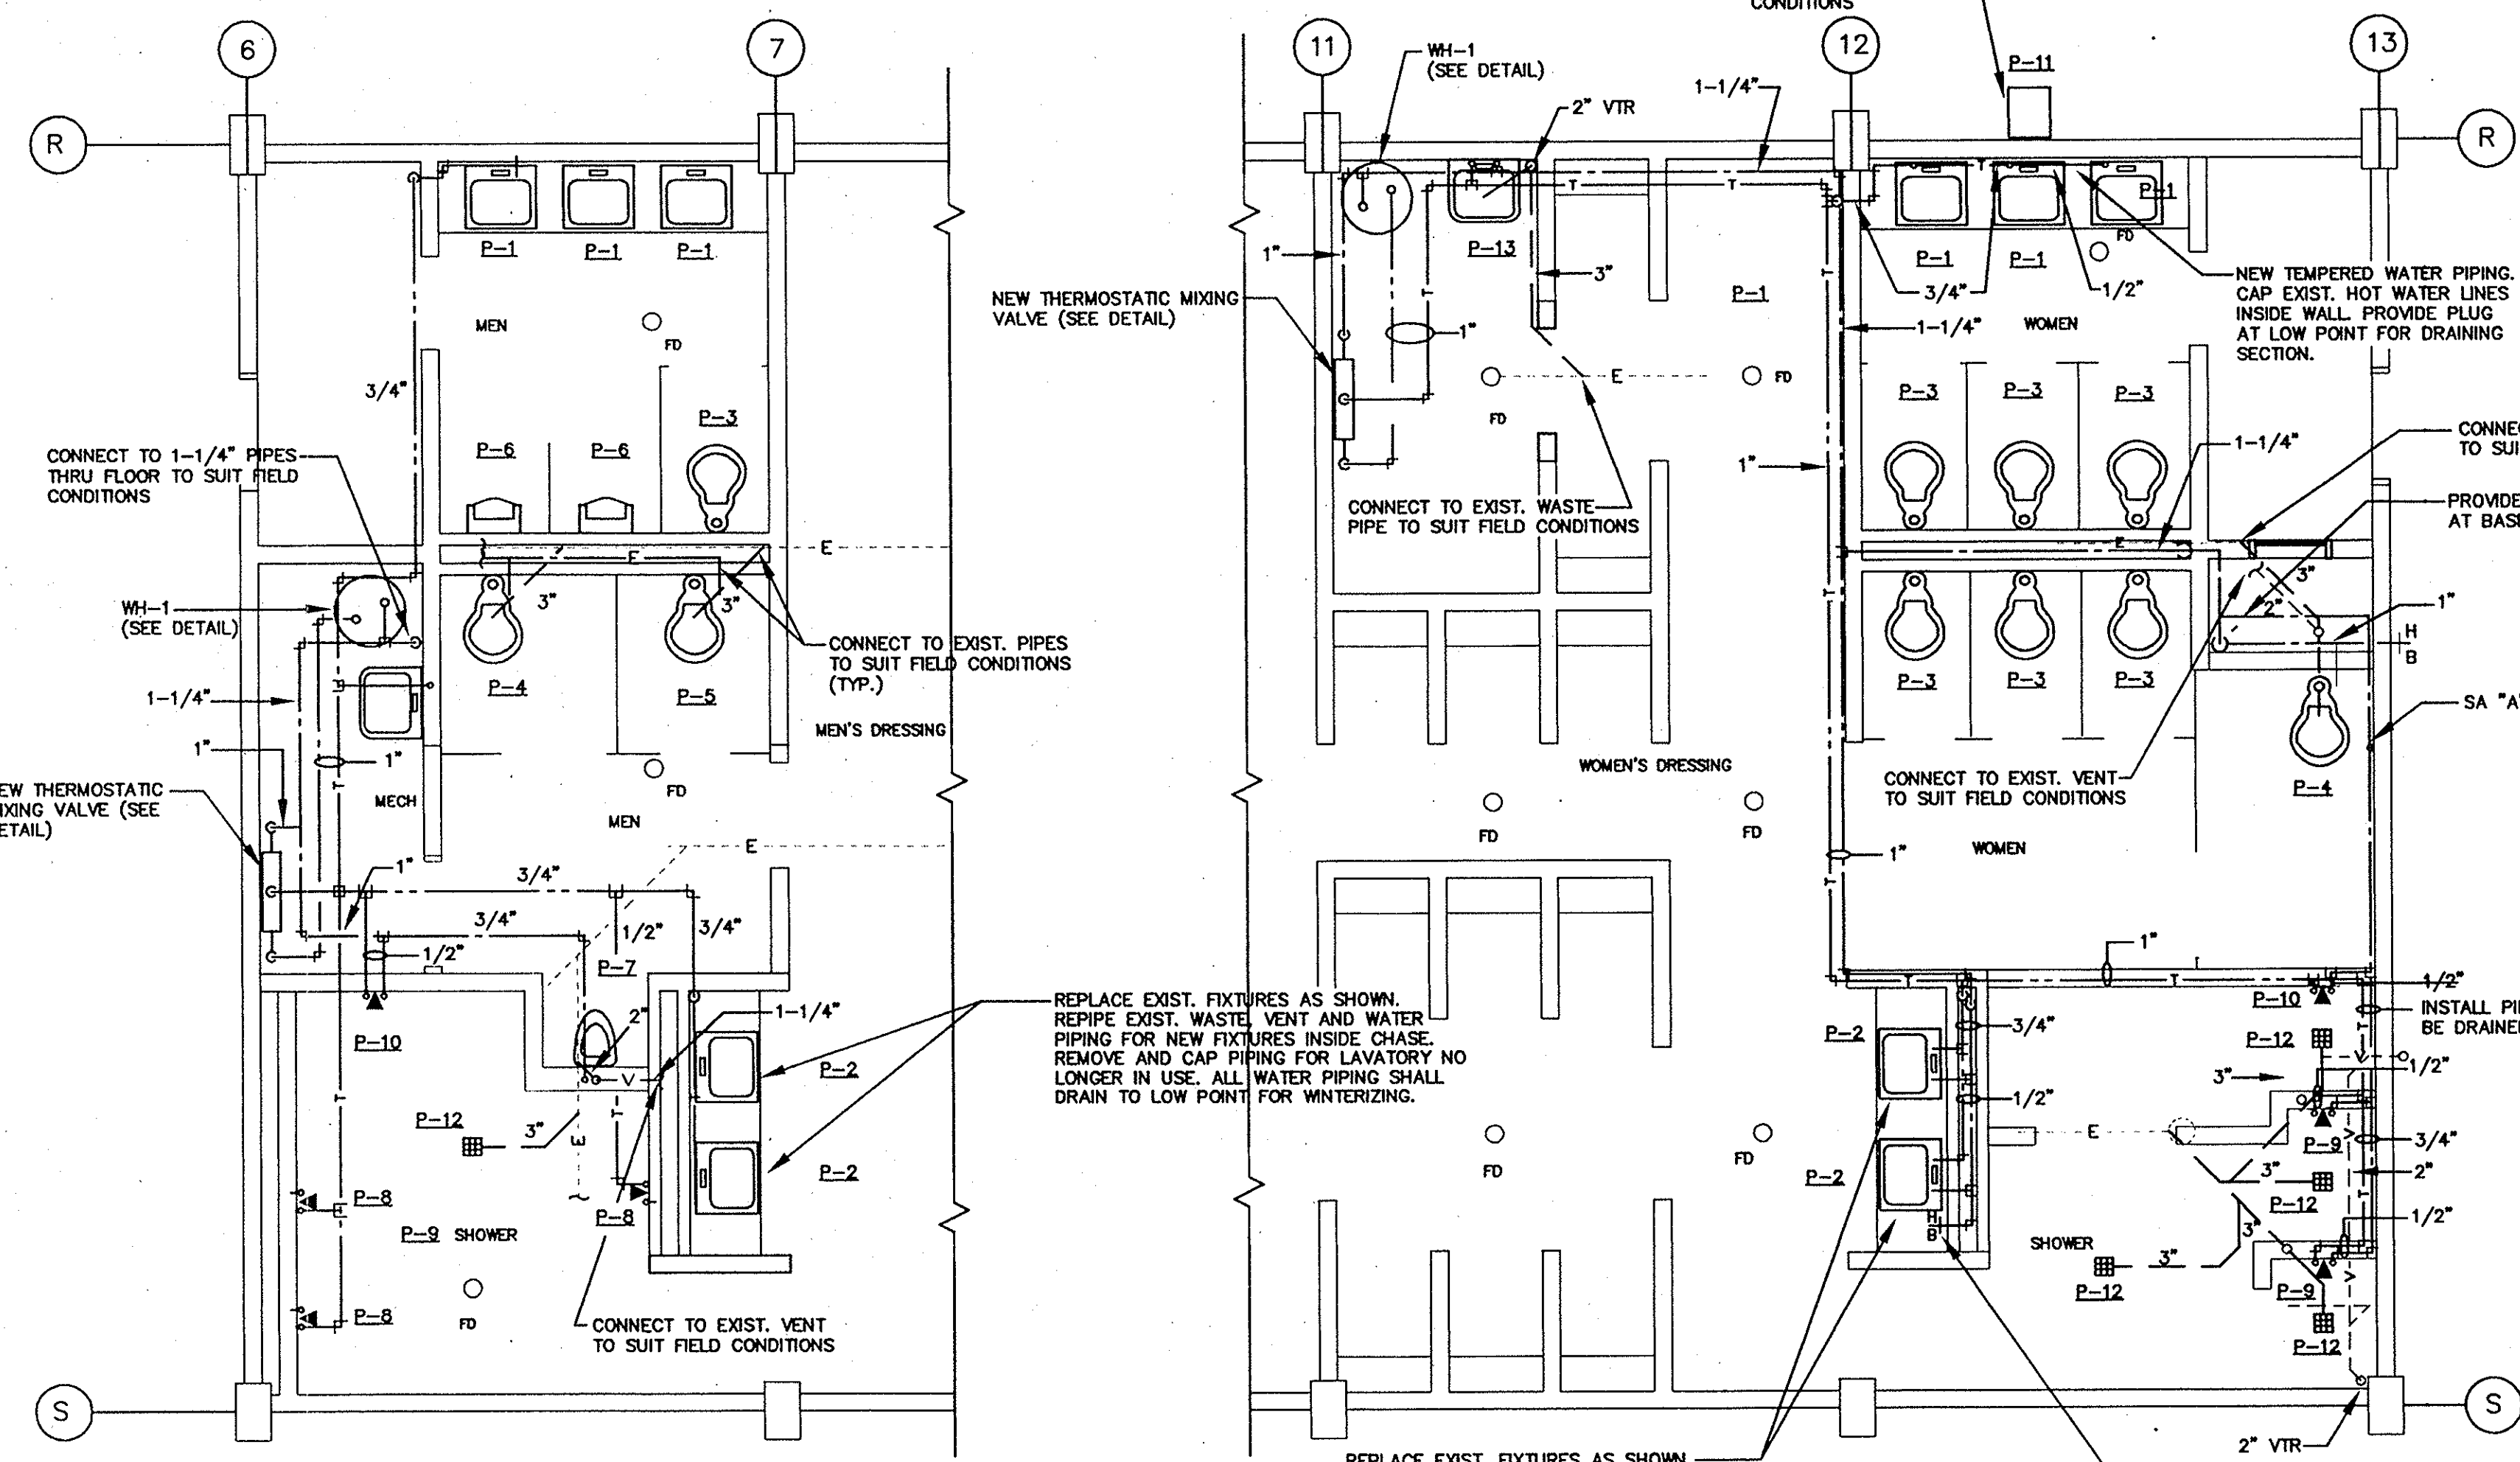


MEN'S LOCKER RM. PLUMBING PLAN
SCALE: 1/4"=1'-0"

WOMEN'S LOCKER RM. PLUMBING PLAN
SCALE: 1/4"=1'-0"

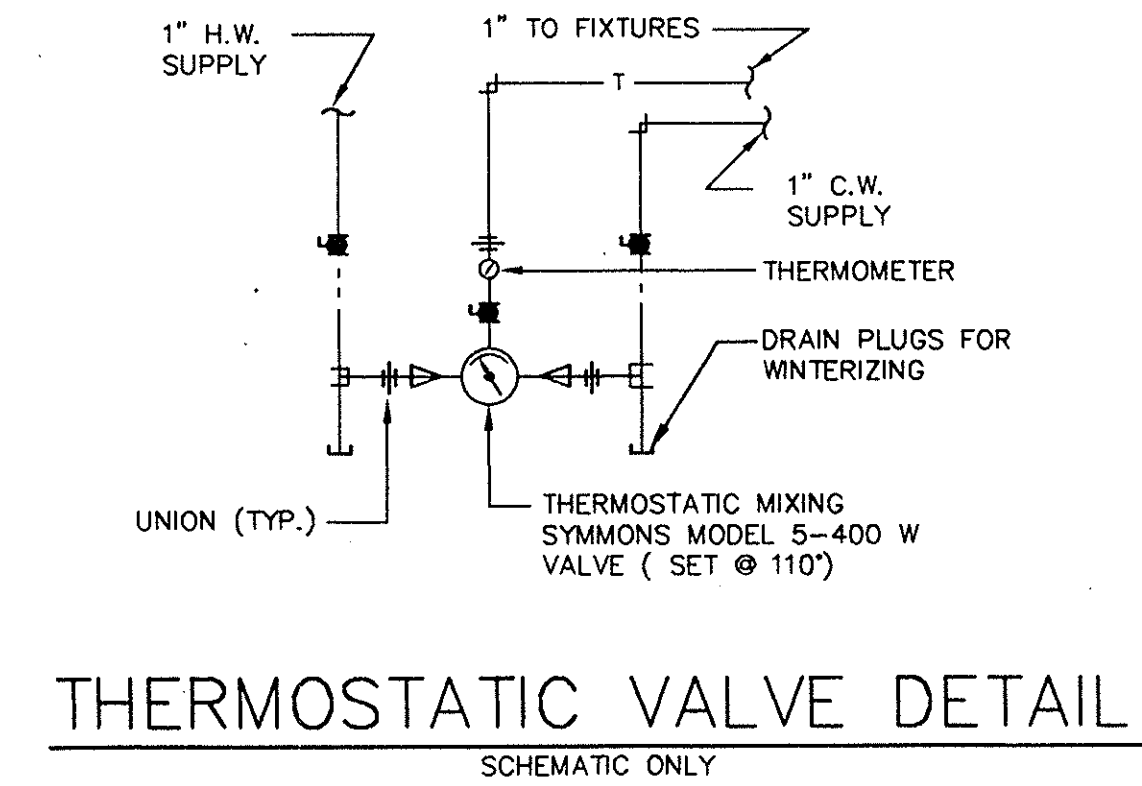

- GENERAL NOTES**
- ALL SECTIONS OF SPECIFICATION SHALL APPLY TO THIS WORK.
 - EXIST. PIPING SHOWN FOR INFORMATION ONLY. CONTRACTOR SHALL VERIFY ACTUAL LOCATION AND SIZES PRIOR TO START OF WORK.
 - INSTALL ALL PIPING SO IT CAN BE DRAINED FOR WINTERIZING OF SYSTEM.
 - EXIST. HOT WATER PIPING UNDER WOMEN'S LOCKER SHALL BE ABANDONED. CAP ALL PIPES, TERMINATE PIPING SO FINISHES CAN BE APPLIED.
 - TESTING: CONTRACTOR SHALL TEST THE PLUMBING SYSTEM FOR LEAKS UPON COMPLETION OF WORK. ANY DEFECTS OR DEFICIENCIES DISCOVERED AS A RESULT OF TESTS SHALL BE IMMEDIATELY REPAIRED AND TEST SHALL BE REPEATED UNTIL THE TEST REQUIREMENTS ARE FULLY COMPLIED WITH.
 - PIPING:
 - A: WATER PIPING SHALL BE TYPE "L" COPPER TUBING.
 - B: WASTE AND VENT PIPING SHALL BE SCHEDULE 40 PVC PIPE AND FITTINGS.
 - C: RUN PIPING ALONG EXIST. STRUCTURAL MEMBERS AND WALLS TO CONCEAL AS MUCH AS POSSIBLE.
 - D: INSULATE HOT WATER AND DRAIN LINES TO LAVATORIES WITH TRUEBRO MODEL 102.
 - SHOP DRAWINGS: THE CONTRACTOR SHALL SUBMIT FOR APPROVAL, A COMPLETE LIST OF THE MATERIALS PROPOSED TO BE USED, GIVING THE MANUFACTURER'S NAME, CATALOG NUMBER OR OTHER APPROVED MEANS OF IDENTIFICATION.

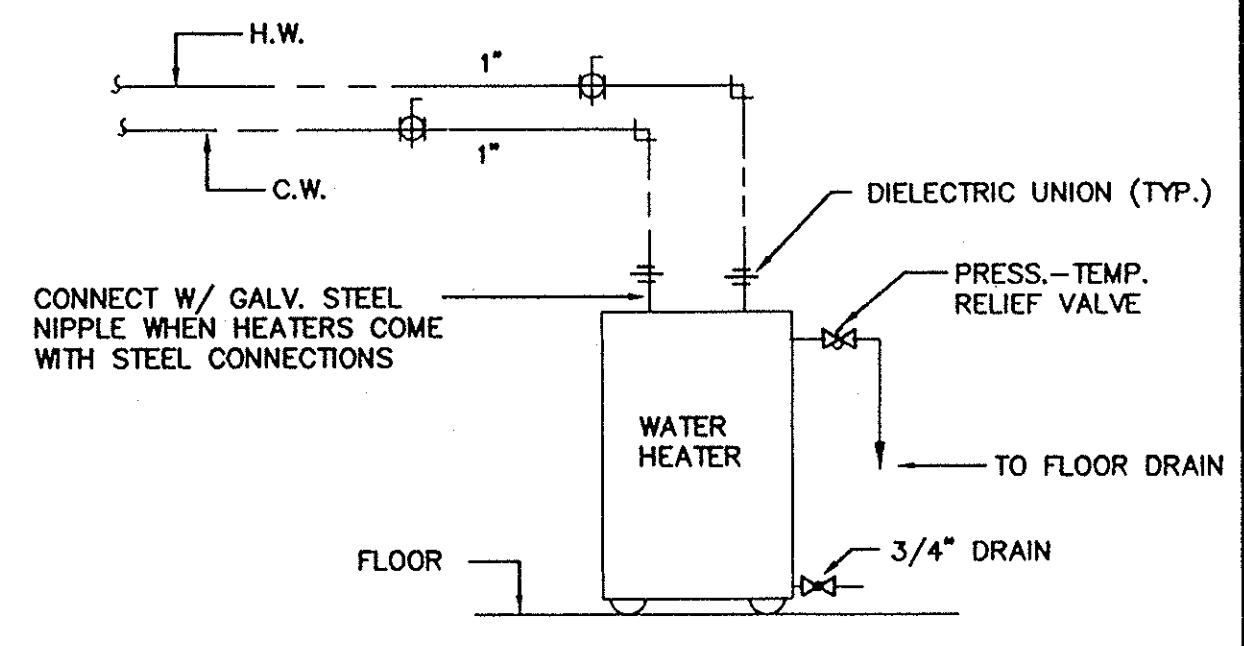

WATER HEATER HOOK - UP
NOT TO SCALE

- PLUMBING LEGEND**
- WASTE PIPING (BELOW FLR.)
 - WASTE PIPING (ABOVE FLR.)
 - - - VENT PIPING
 - COLD WATER
 - HOT WATER
 - - - TEMPERED WATER
 - - - EXISTING PIPING
 - - - PIPING TO BE REMOVED
 - BALL VALVE
 - CO CLEANOUT
 - H— FREEZE-PROOF HYDRANT
 - EXIST. FLOOR DRAIN
 - NEW FLOOR DRAIN
 - S 'A' SHOCK ABSORBER. 'A' IS SIZE

AS BUILT
 Basarrate & Assoc.
 Consulting Engineers
 Chattanooga, Tennessee

DISTRIBUTION RECORD:	ISSUED TO:	QUANTITY:	DATE:	REVISION RECORD:	No.	DESCRIPTION:	DATE:

planning associates, inc.
architects
 1112 MCALLEN AVENUE
 CHATTANOOGA, TN. 37404
 423-622-5121

REPLACE SWIMMING POOL
 NORRIS DAM STATE PARK
 LAKE CITY, TENNESSEE
 SBC # 126/063-01-97A

DATE: 10/10/01
 JOB # 371
 SHEET #
 SUP-8
 FILE: NOR-SUP8