


SPILL ON GRADE @ SLAB EDGE EL. 1282.66 (TYP. UNLESS OTHERWISE NOTED)

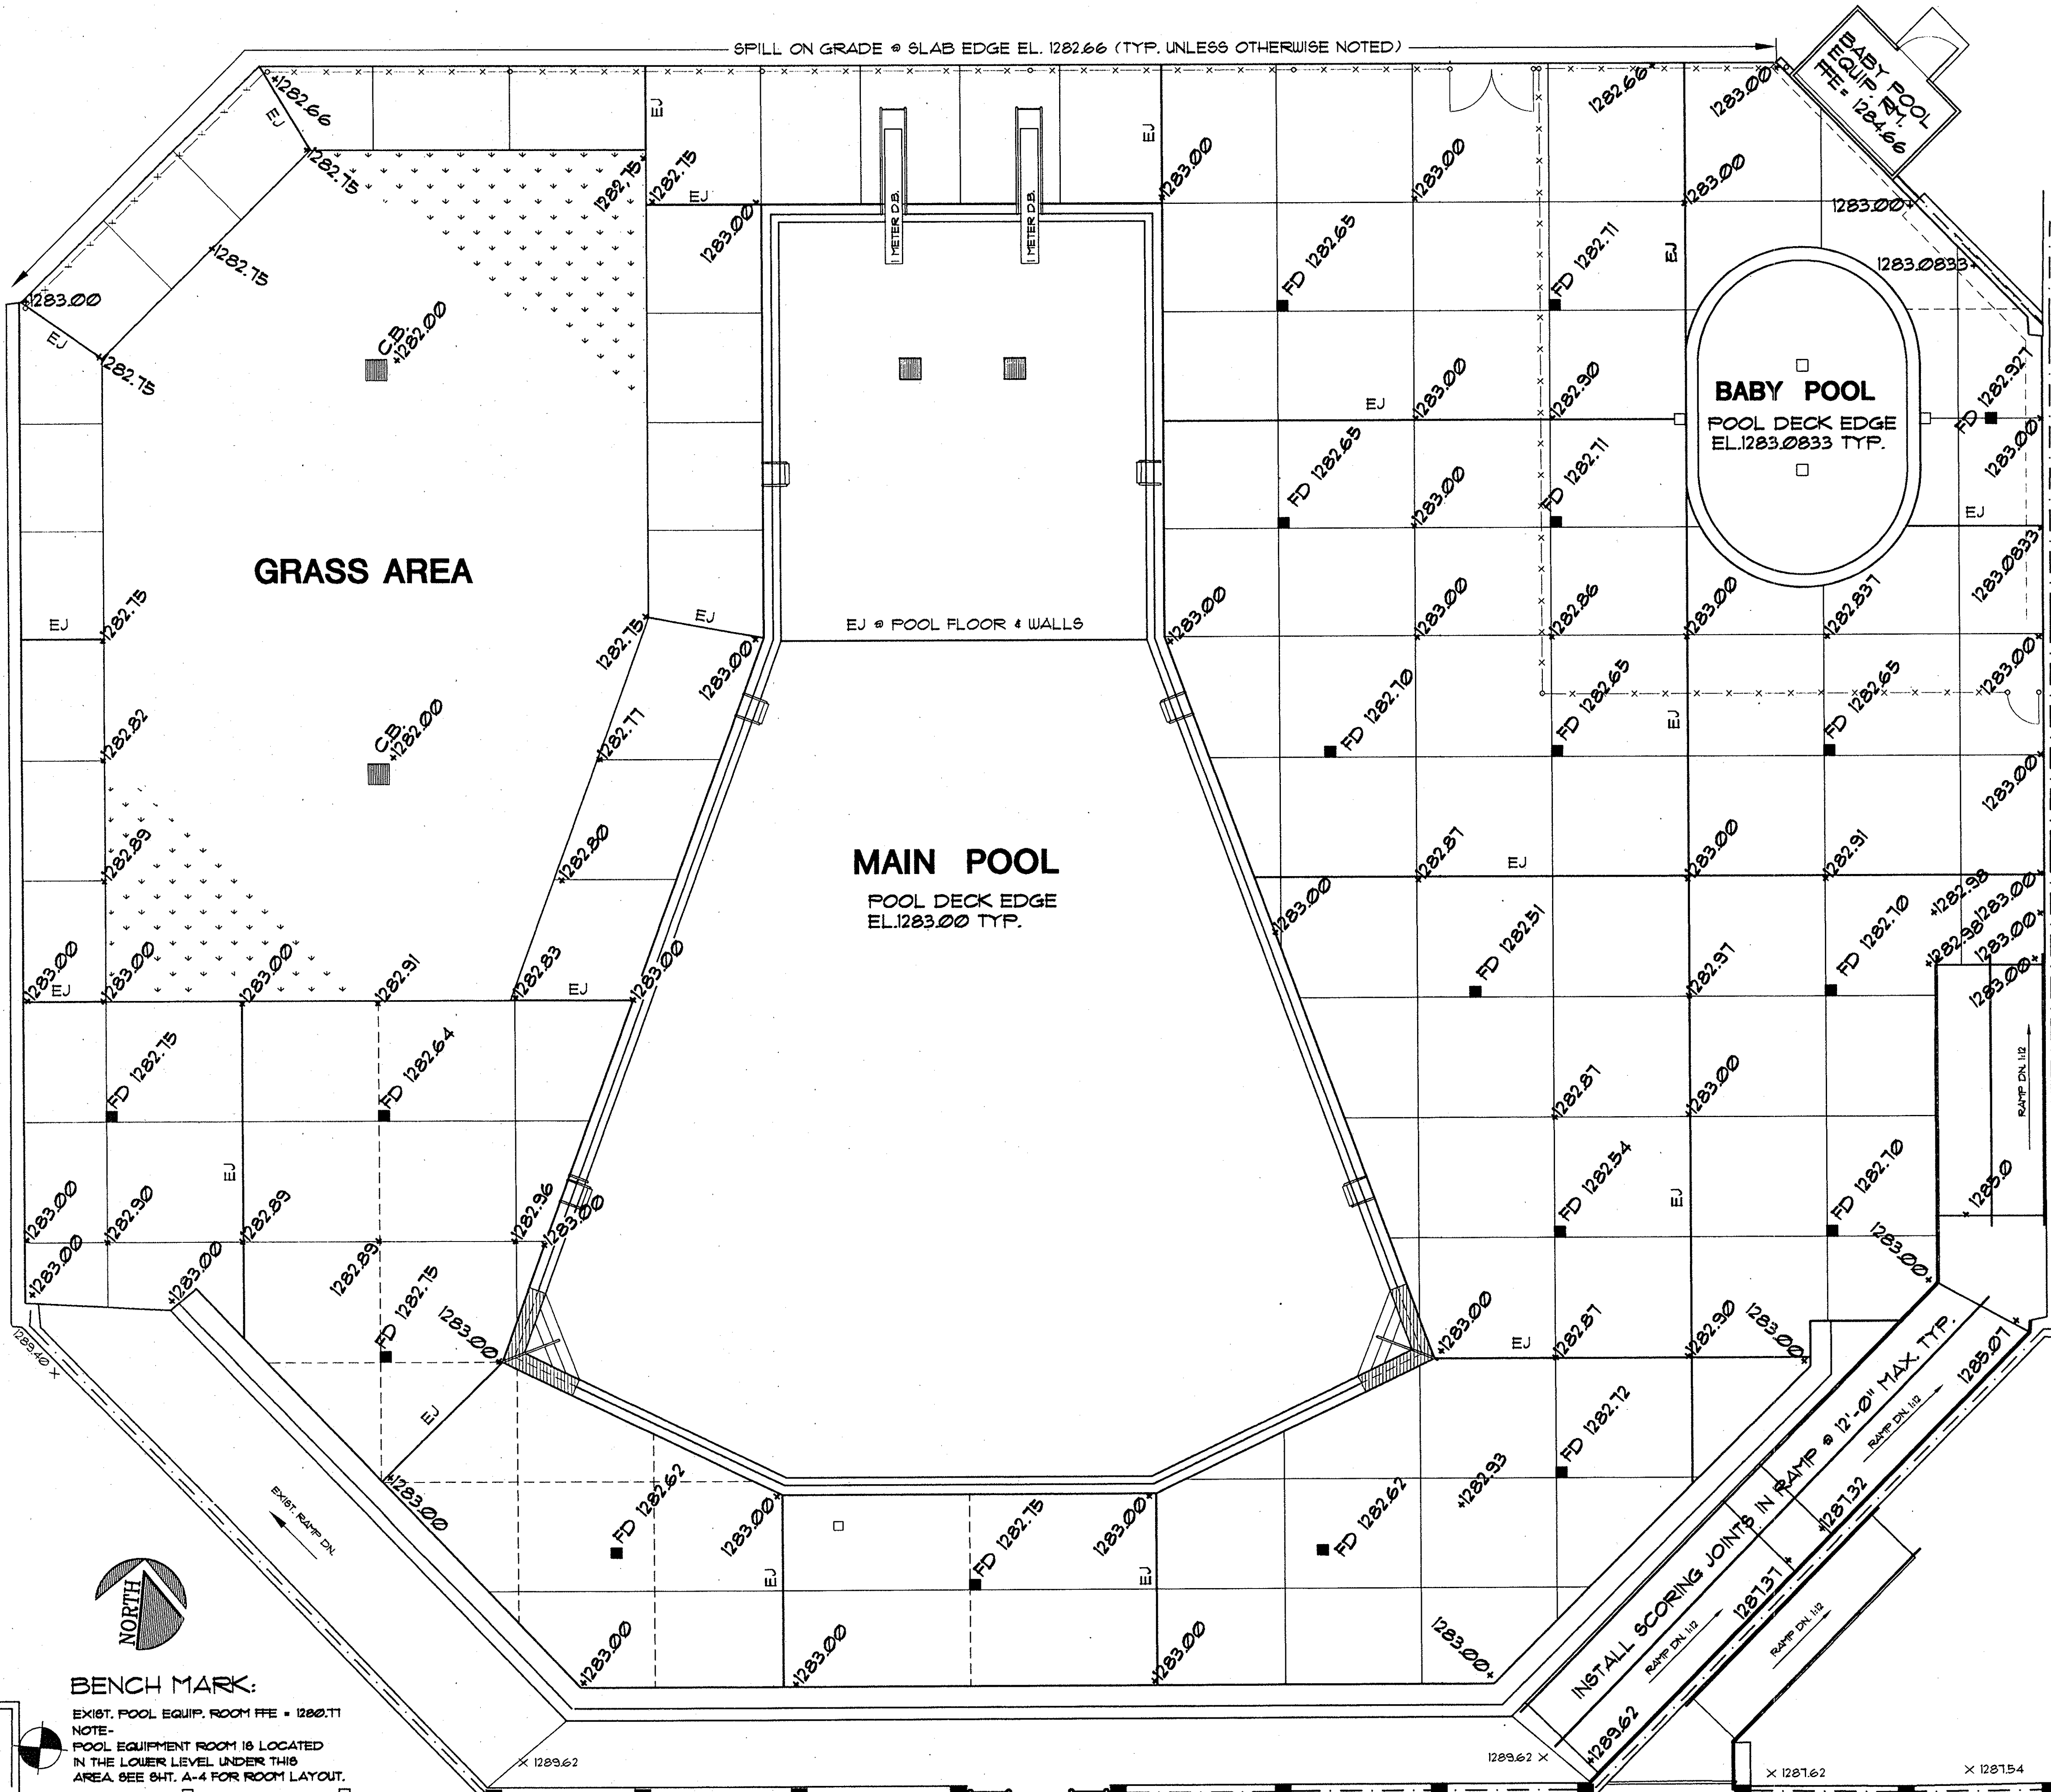




GRASS AREA

MAIN POOL

POOL DECK EDGE
EL. 1283.00 TYP.

BABY POOL

POOL DECK EDGE
EL. 1283.00 TYP.

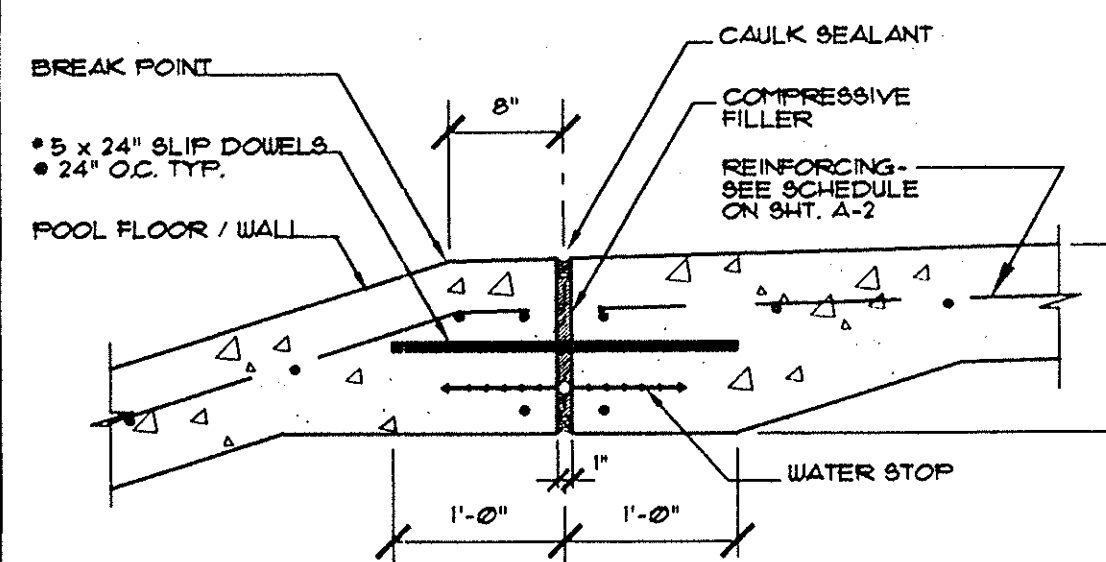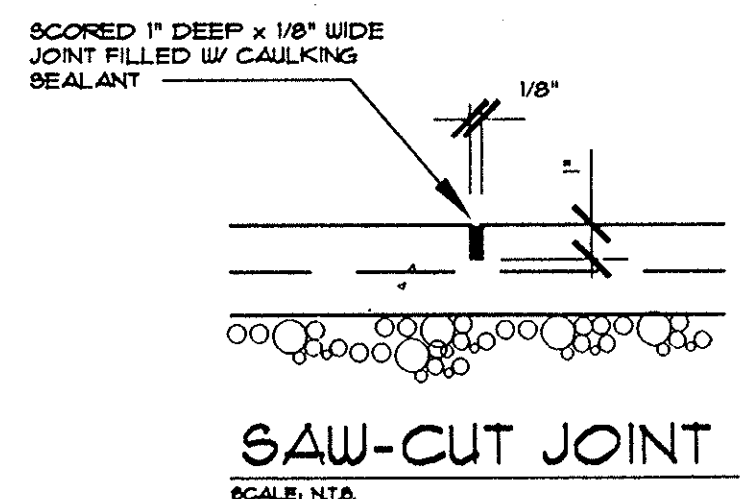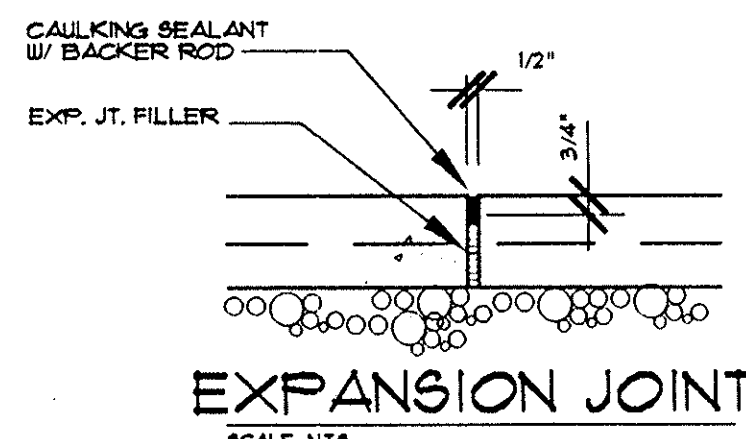

DECK NOTES:

MIN. DECK SLOPE (TO DRAIN) = 1/4" PER FOOT
MAX. DECK SLOPE (TO DRAIN) = 3/8" PER FOOT
EXPANSION & SAW-CUT JOINTS SHALL BE AS SHOWN
ON THIS PLAN.

INSTALL SCORING JOINTS @ 12'-0" O.C. MAX. IN ALL
NEW CONC. RAMPS, TYP.

PROVIDE CONT. EXPANSION JOINT AROUND THE
PERIMETER OF MAIN POOL & BABY POOL & WHERE
CONC. DECK ABUTTS ANY VERTICAL SURFACE.

LEGEND:

X 1281.62 EXISTING SPOT ELEVATIONS

+1283.00 NEW SPOT ELEVATIONS

FD 1282.70 FLOOR DRAIN ELEV.

EJ EXPANSION JOINT

SAW-CUT JOINT

FILENAME: NOR-A5

PLOT: 1/8"=1'-0"

AS-BUILT

DISTRIBUTION RECORD:		REVISION RECORD:	
ISSUED TO:	QUANTITY:	DATE:	DESCRIPTION:

planning
associates, inc.
architects

1112 MCALLIE AVENUE
CHATTANOOGA, TN 37404
423-622-5121

REPLACE SWIMMING POOL
NORRIS DAM STATE PARK
LAKE CITY, TENNESSEE
SBC # 126/063-01-97A

DATE: 10/04/00
JOB #: 371
SHEET #: A-5